

# openreach

a BT Group business



Luton Borough Council  
Legal Services  
Town Hall  
Luton  
LU1 2BQ

Tele 01582-403279

For the attention of Mrs J White

Our Ref. BVD465/ 31841  
Your Ref. JMW/MP/001900

23 March, 2012

Dear Madam

**LEYHILL DRIVE GATING ORDER No LD 2012**

Thank you for your notice.

British Telecommunications Plc have no objections to the proposals.

Please refer to attached drawing showing existing Openreach plant.

If you are performing excavation works that is necessary to install the proposed gates, please contact our Plant Protection Office on 0800 917 3993 for a free onsite mark up of Openreach plant.


Any damage caused is repaired on a chargeable basis.

Should you require further information please contact our Luton Office.

Yours Faithfully,

A. Rayner  
Repayments Project Manager



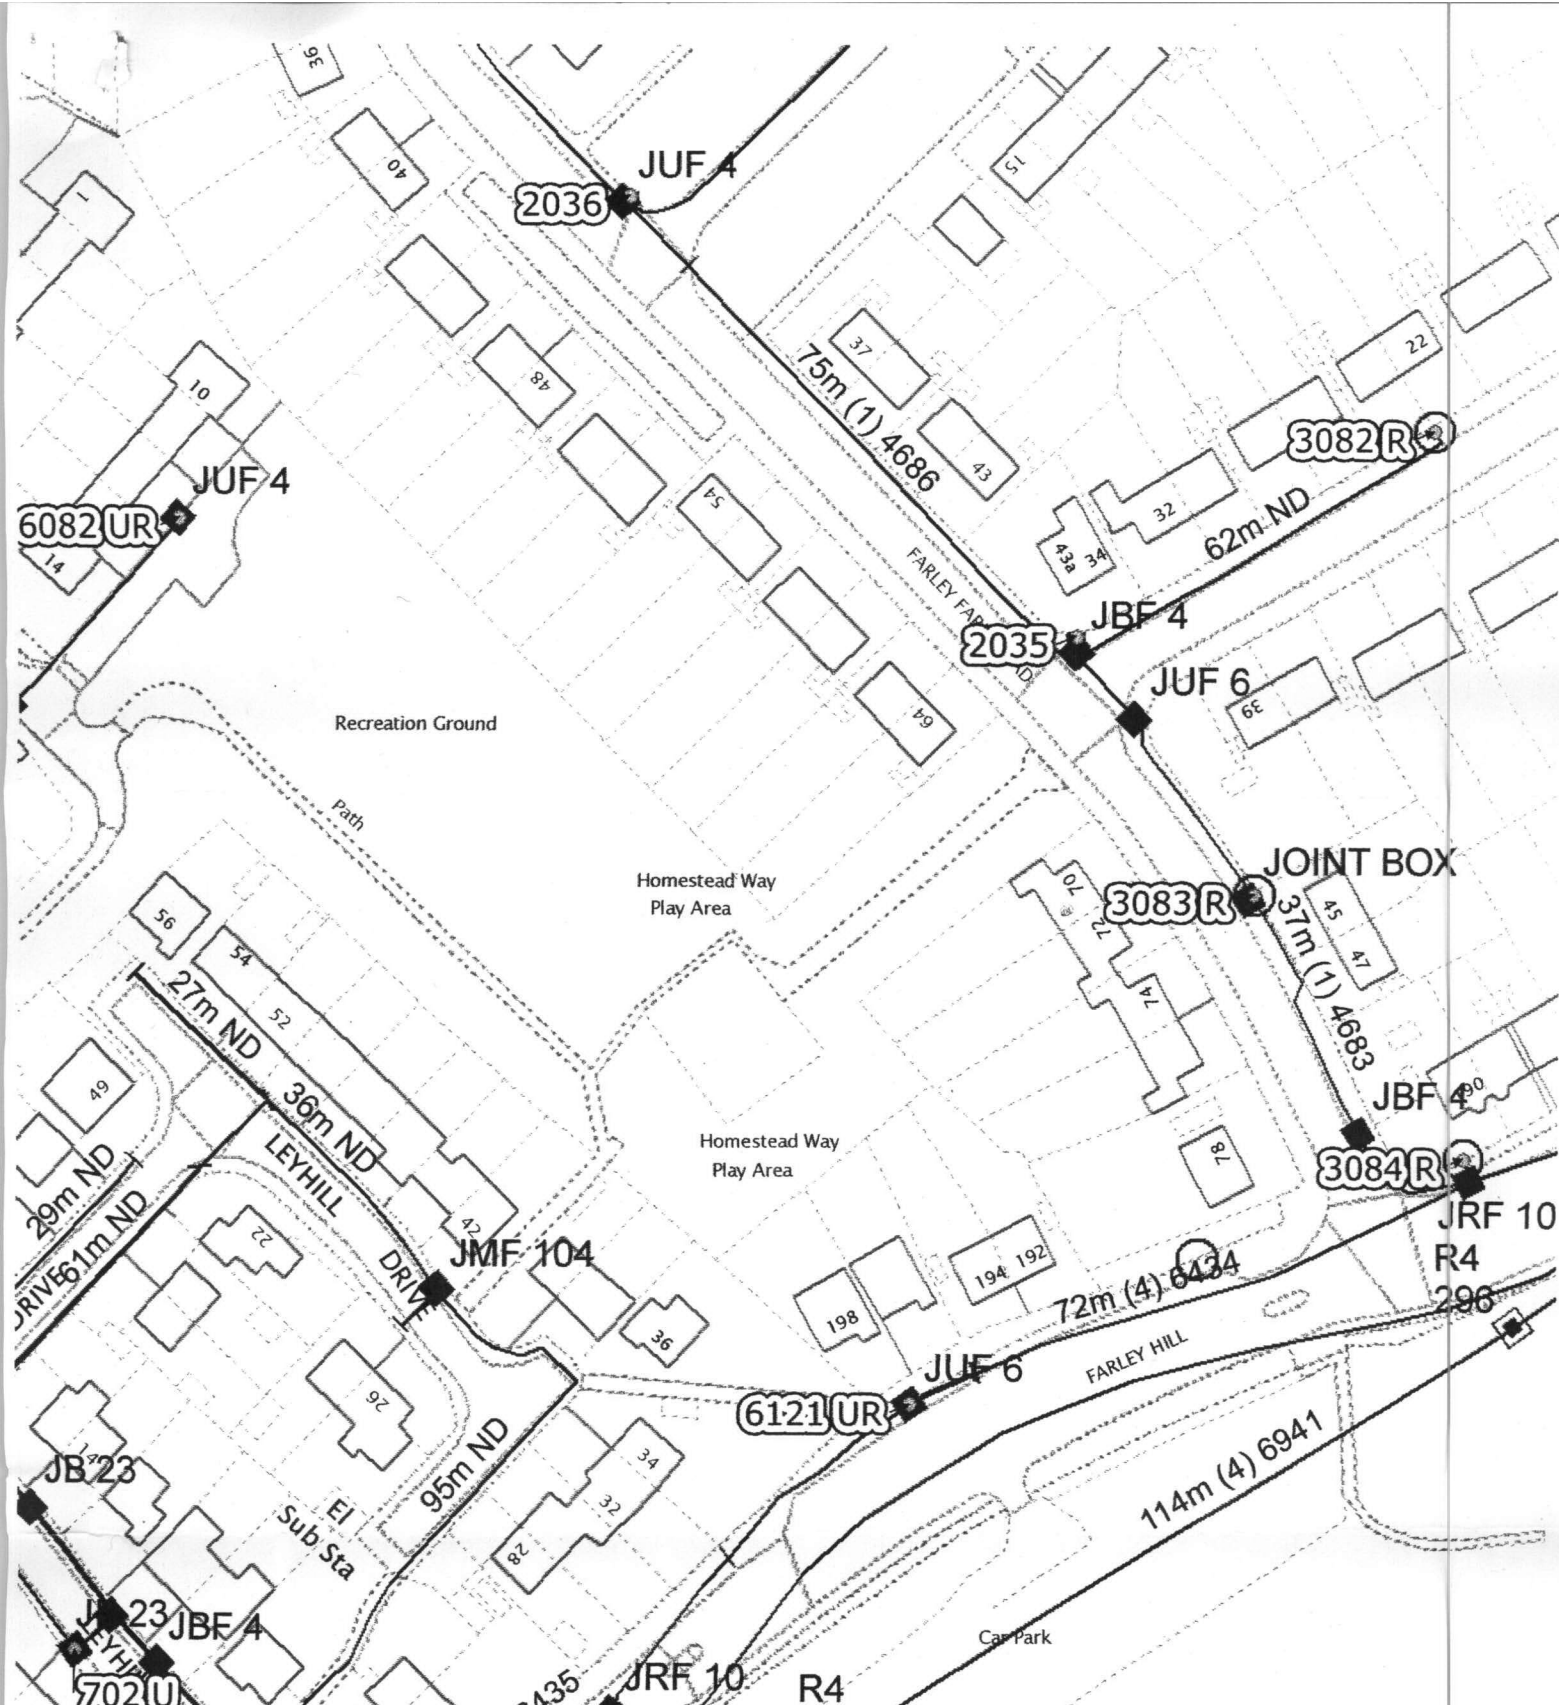

BT NETWORK RECORD SYMBOLS			
	UNDERGROUND PLANT		CABINET
	above as proposed		DISTRIBUTION POINT may also be circular
	OVERHEAD PLANT		POLE
	above as proposed		JOINTING POST
	MANHOLE		PHONE KIOSK
	JOINT BOX		IN-BOX FLANT
	above as proposed		IN-BOX FLANT
	BURIED JOINT		
BT BOUNDARY LINES (variable sizes)			